

出来形管理図 < 例 >

開発者名

工事名射水市〇〇地内〇〇工事

請負者

箇所射水市〇〇地内

工期平成 年 月 日 ~ 平成 年 月 日

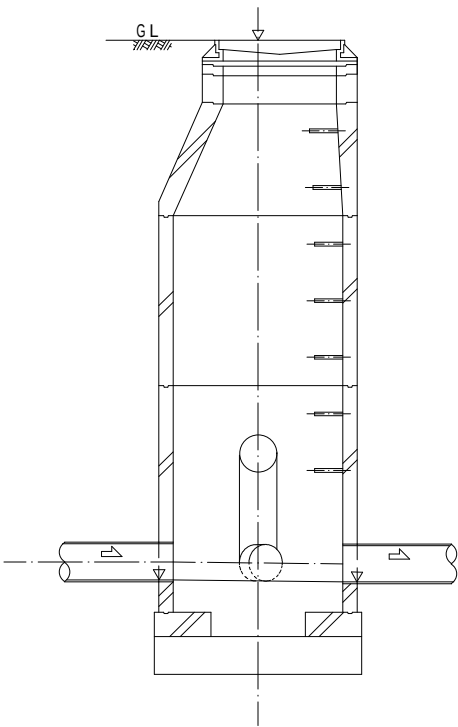
平 面 図縮尺

The diagram shows a sewerage layout across seven lots. Lot 123-1 is on the top left, 123-2 in the top middle, and 123-3 on the top right. Lot 123-4 is on the bottom left, 123-5 in the bottom middle, 123-6 in the bottom right, and 123-7 on the far right. A main sewer line runs horizontally through the middle, with a manhole M1 on the left and M2 (1号マンホール) on the right. Various pipe segments are shown with their diameters (e.g., φ100, φ150) and elevations. A north arrow is located in the top right corner.

計画値
実測値 (朱書or下線)

凡 例	
記 号	名 称
—●—	既 設 管 路
—●—	新 設 管 路
○	1 号 マン ホ ール
○	2 号 マン ホ ール
⊗	小 口 径 マン ホ ール
—○—	副 管 付 マン ホ ール
○	汚 水 樹 及 取 付 管
1-1	管 番 号
PRP φ 150 3.0 % 32.0 3.847 3.791	本 管 (774-4 ~ 774-5) 下流管底高 上流管底高
3.0 φ 150 (2.6) H=1.00	取付公共樹 取付管延長 管径 (上流Mからの距離) 公共樹深さ

出来形管理図 < 例 >

開発者名			工事名 射水市 ○ ○ 地内 ○ ○ 工事				請負者				箇所 射水市 ○ ○ 地内		工期 平成 年 月 日 ~ 平成 年 月 日						
データ記録表	試験番号		1		2		3		4		5		6		計		測定月日		
	地盤高	設計値	5.10		5.00		4.95		5.00		5.08				単位〔 〕		測定者		
		実測値	5.13		5.03		5.01		5.03		5.05						規格値	上限	+30
		設計値との差	+3		+3		+6		+3		+3							下限	-30
	管底高		上流	下流	上流	下流	上流	下流	上流	下流	上流	下流					測定基準	基準高 人孔天端高	
		設計値		3.741	3.646			3.104	3.047	3.046	3.013								
		実測値		3.740	3.645			3.105	3.045	3.045	3.012								
		設計値との差		-1	-1			+1	-2	-1	-1								
測点		小口径マンホール M 1		1号マンホール M 2		1号マンホール 既設 M 3 0 5 1		1号マンホール M 2		1号マンホール 既設 M 3 0 5 2				略 図					
出来形管理図	UCL +30																		
	+20																		
	+10																		
	CL 0																		
	-10																		
	-20																		
	LCL +30																		
記事	施工月日																		

出来形管理図 < 例 >

開発者名		工事名 射水市 ○ ○ 地内 ○ ○ 工事		請負者		箇所 射水市 ○ ○ 地内		工期 平成 年 月 日 ~ 平成 年 月 日			
上流マンホール 下流マンホール 取付管 VU φ 100 公共柵 A B C C' A : 上流マンホールからの距離 B : 本管から公共柵までの距離 C : 公共柵の深さ C' : ドロップ底までの深さ								計	測定月日		
								単位 []	測定者		
									規格値	上限	
下限	-200										
	測定基準	取付管延長									
	管番号	道路左右	公共柵設置箇所	A (m)	B (m)	C (m)	C' (m)	底 . 付 ドロップ	備 考		
1	1 - 1	右		0.00	4.00	1.00		底付			
2	1 - 1	左		2.70	4.00	1.00		底付			
3	1 - 1	左		4.80	4.00	1.00		底付			
4	1 - 1	右		8.70	4.00	1.00		底付			
5	1 - 1	右		11.10	4.00	1.00		底付			
6	1 - 1	左		18.00	4.00	1.00		底付			
7	1 - 1	右		20.50	4.00	1.00		底付			
記事	施工月日										

C

C

B

2.0%